



Autocad File Format 2013 required

Please refer to the SEQ WS&S D&C Code Asset Information Specification Appendix C for further details, refer also to Readme file that is supplied with drawing template for quick reference to requirements for As Constructed submission

- 1 - Scale of drawing
- 2 - Populate attributed title block
- 3 - Unitywater Drawing number, supplied via email request to the relevant Development Inspector, drawing numbers can be requested after start up meeting and any time up to On Maintenance request/notification
- 4 - Insert Consultants/Surveyors logo
- 5 - Populate RPEQ Engineers details - signature on PDF
- 6 - Populate Surveyor's details - signature on PDF
- 7 - Populate revision box (part of attributed title block)

5

ENGINEER'S CERTIFICATION

I, _____, hereby certify that:

- The information contained in this drawing / document is in compliance with approved drawings and design.
- The new water and sewerage works defined by this drawing have been designed and constructed in accordance with the SEQ Code.
- This represents an accurate record of as-constructed works
- I accept responsibility for the information contained in this drawing / document.

RPEQ (signature) RPEQ No. _____ Date:

6

REGISTERED SURVEYOR'S CERTIFICATION


I, _____, hereby certify that the vertical and horizontal locations and dimensions shown on this plan are a true and correct record and were located by survey.

Registered Surveyor (sig.) Reg. Surveyor No. _____ Date:

COORDINATE DATUM NOTE:
 HORIZONTAL COORDINATES(E,N) SUPPLIED ARE MAPPING GRID OF AUSTRALIA(MGA), ZONE 56 BASED ON THE UNIVERSAL TRANSVERSE MERCATOR PROJECTION AND THE GEOCENTRIC DATUM OF AUSTRALIA 1994.
 HORIZONTAL DATUM DERIVED FROM PSM160605, E 496434.400, N 7050402.659.
 LEVELS SUPPLIED ARE ON THE AUSTRALIAN HEIGHT DATUM(AHD)
 LEVEL DATUM DERIVED FROM PSM160605 RL 20.016 (AHD)

7

1

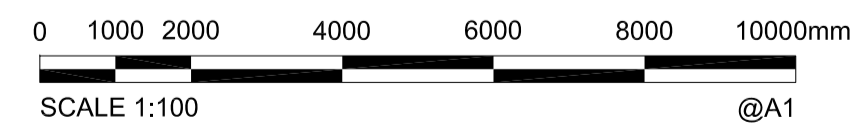

AS CONSTRUCTED

A1

INDEX	DATE	REVISIONS	DRAWN	CHECKED	PASSED

DRAWN	CHECKED	PASSED	INITIALS	DATE

4



Unitywater

2

SHEET OF SHEETS	SCALE
REVISION DATE	REVISION
DISCIPLINE CODE	
DRAWING NO.	3